

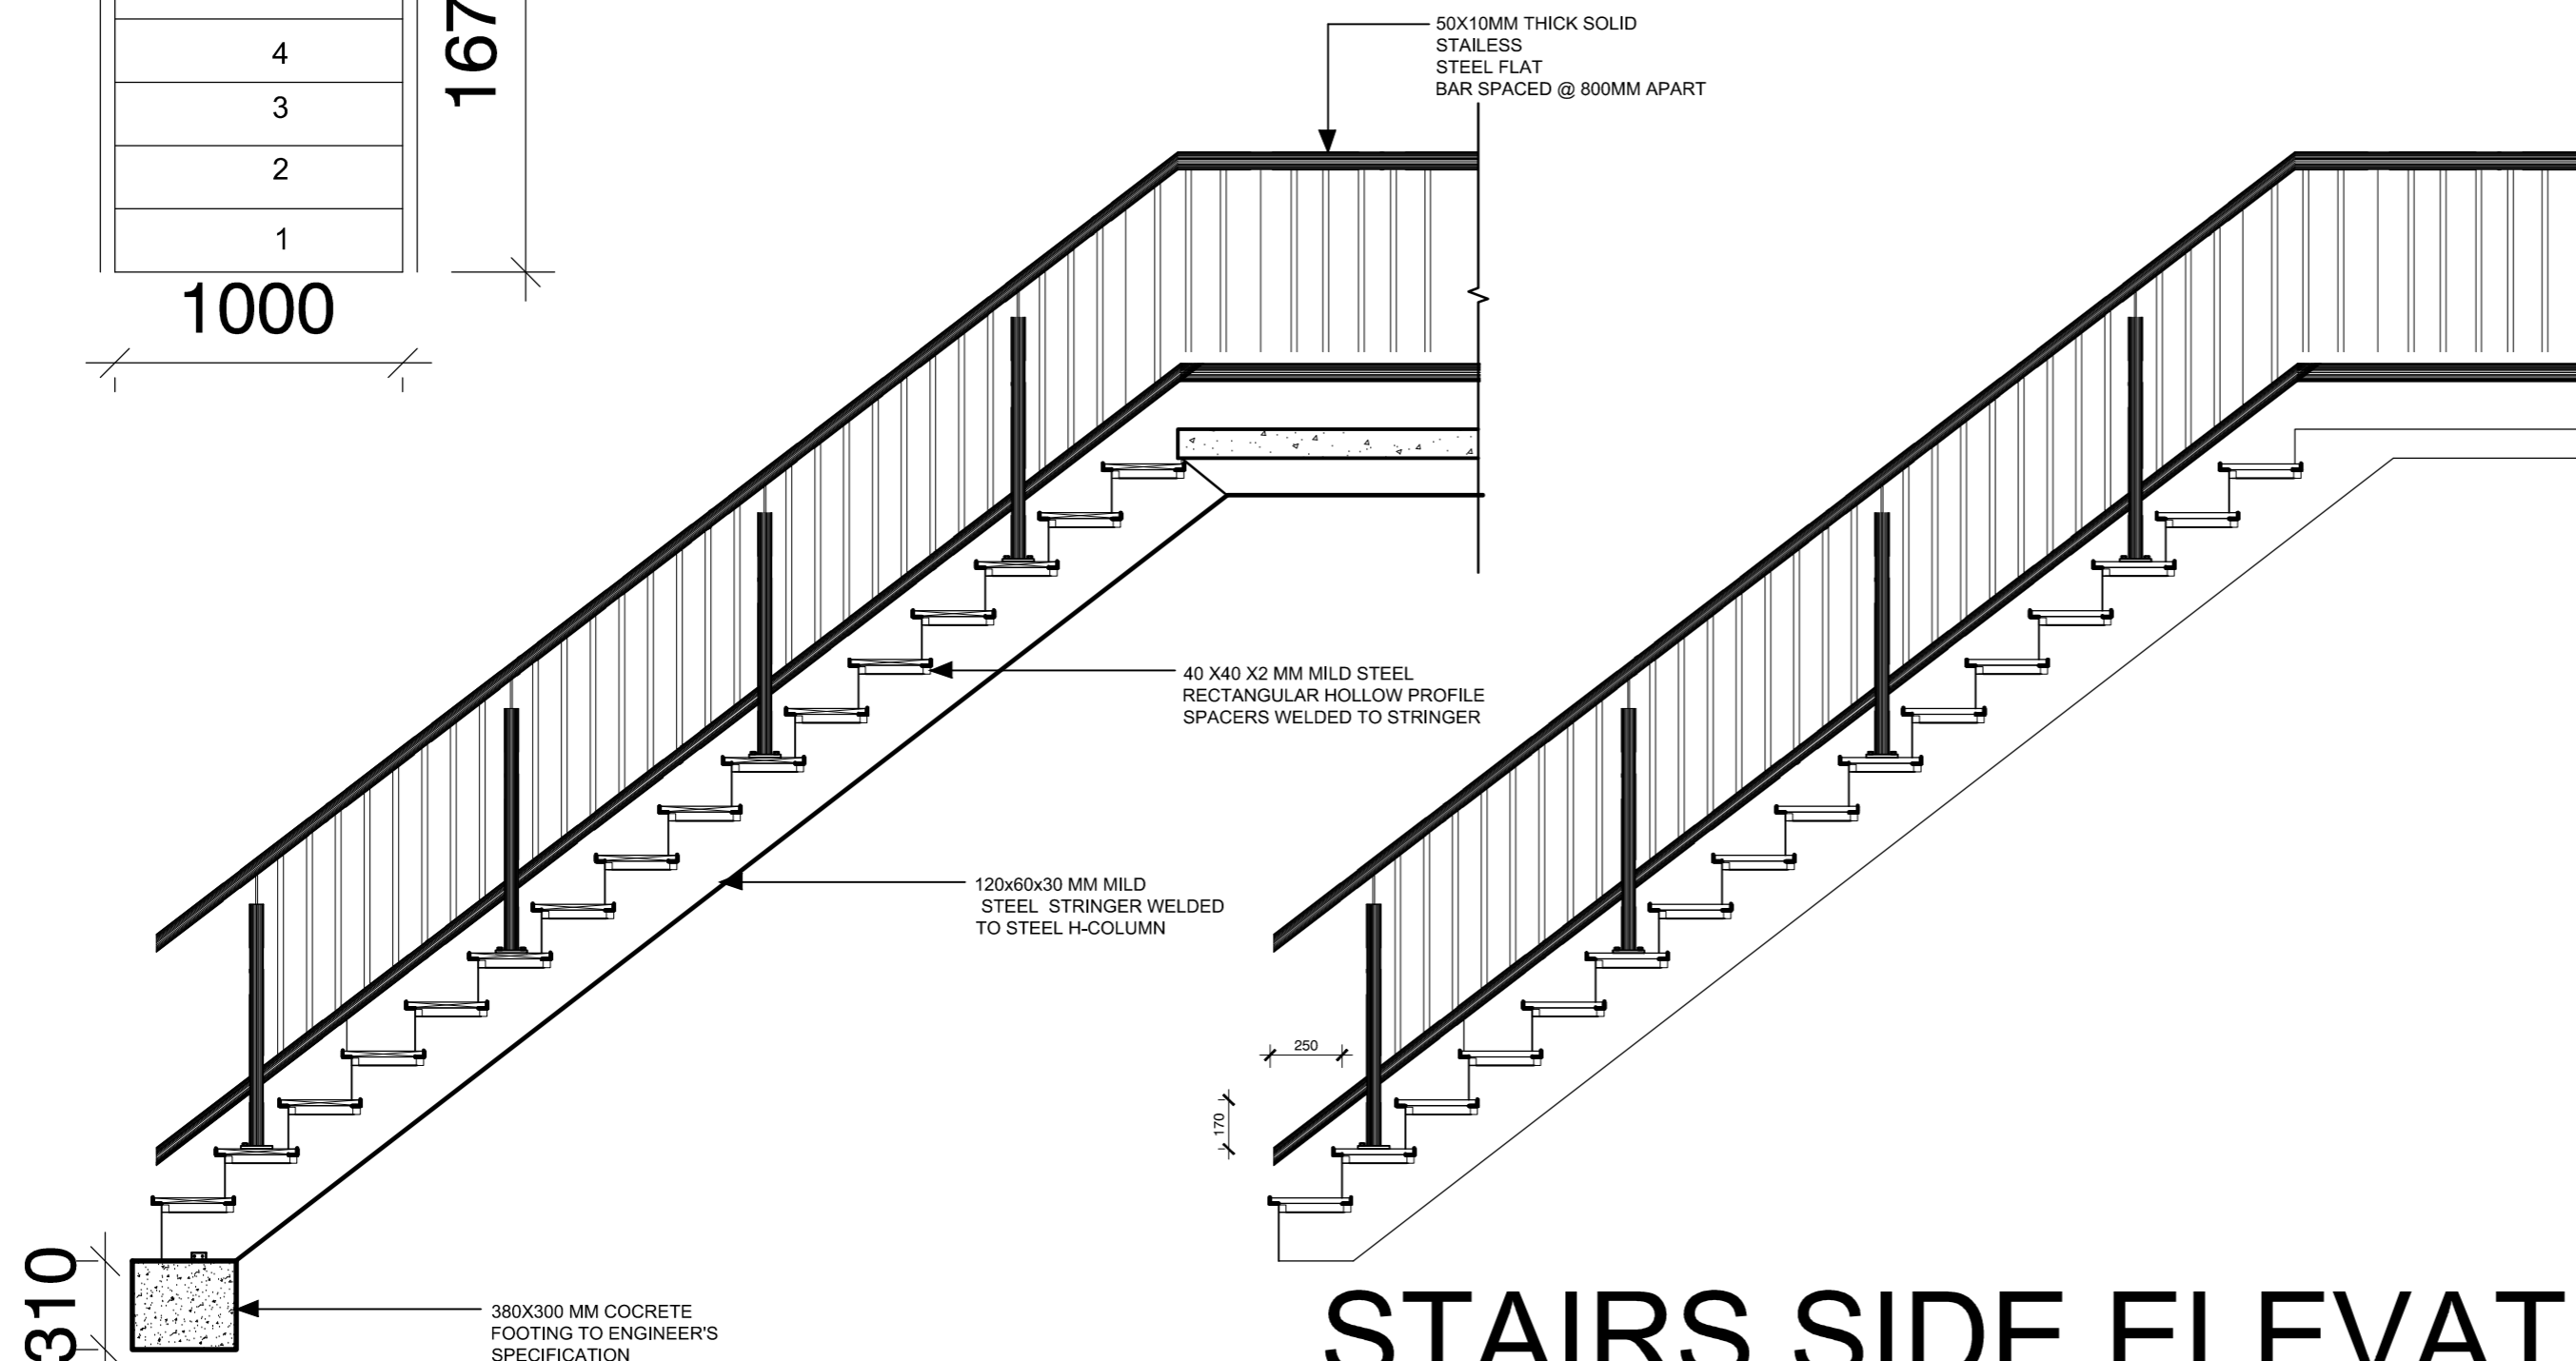
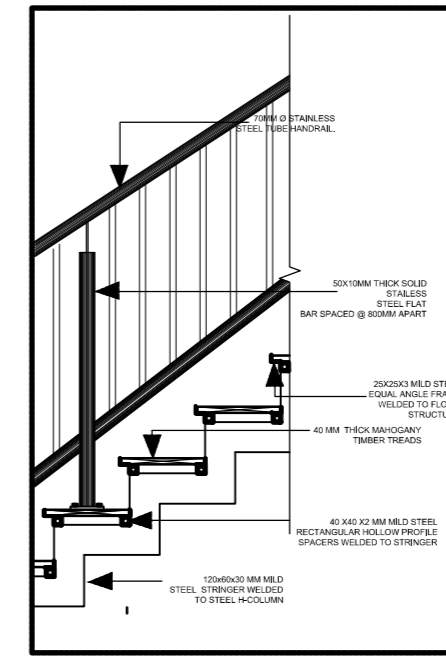


# STAIRS FLOOR PLAN

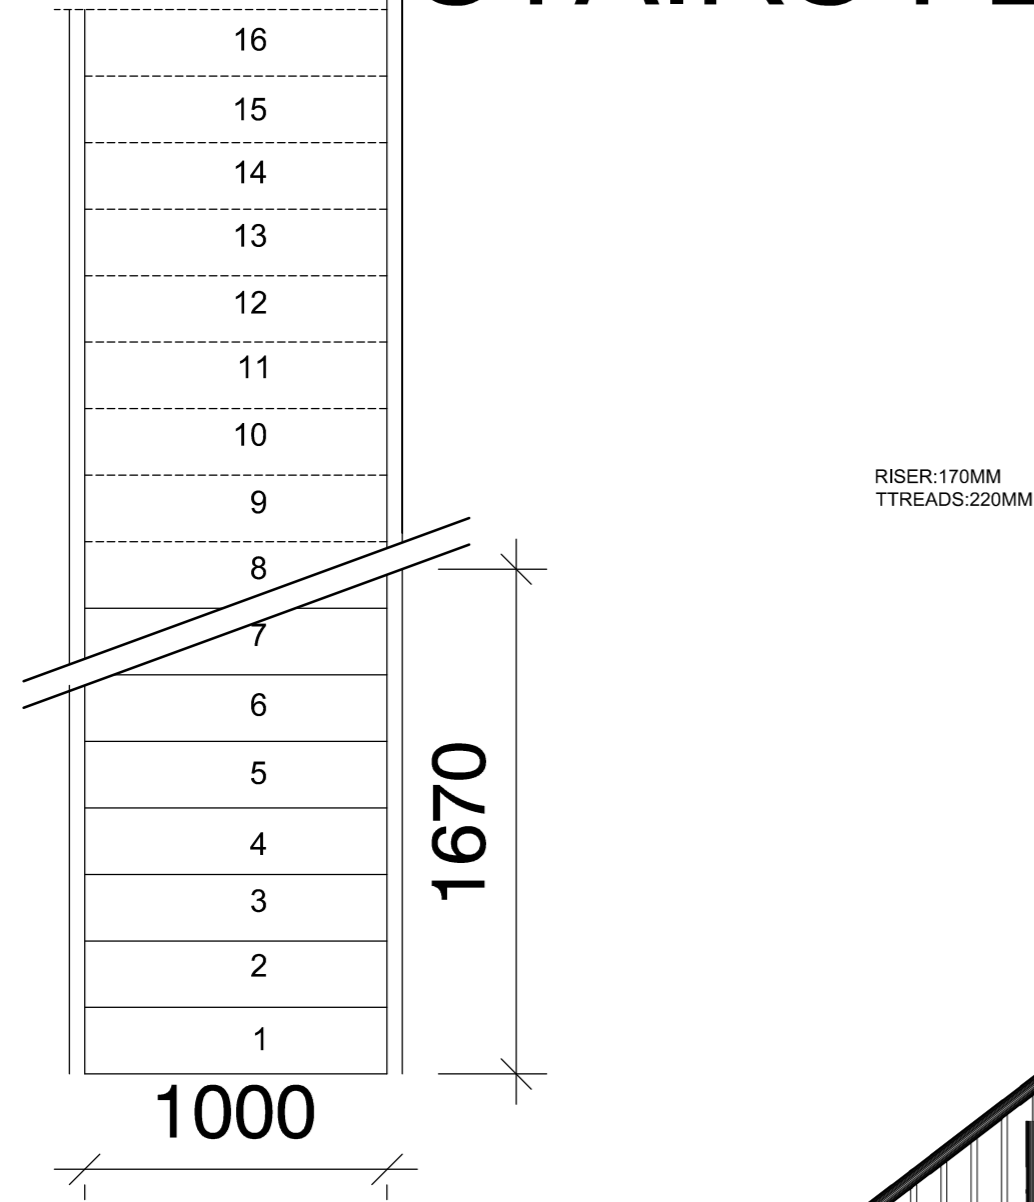

# STAIRS SIDE ELEVATION

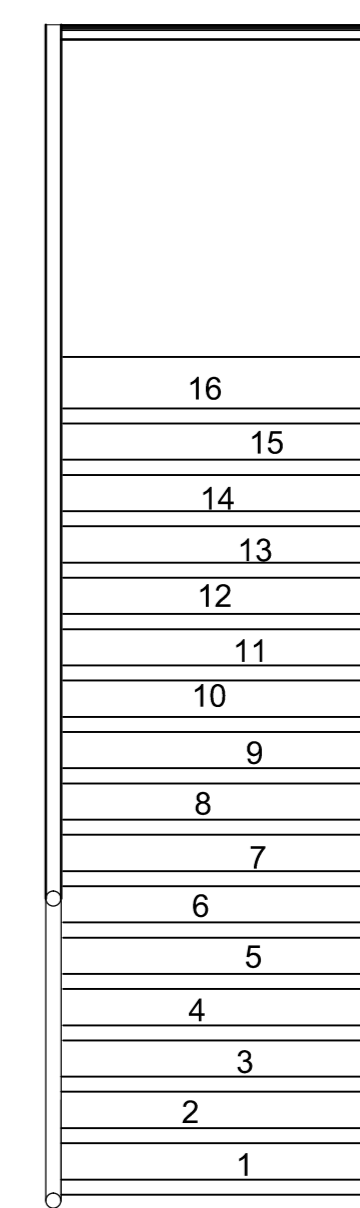

# STAIRS FRONT ELEVATION

# STAIRS SECTION



**GENERAL NOTES**  
Quality of all materials and workship to comply with the S.A.B.S and B.S.S spec and shall confirm to the minimum standards specified in the preambles in the **BOQ**.  
Any errors, discrepancies or omissions to be urgently reported to the **Architect**.  
**Contractor** is responsible for setting out of construction.

**Contractor** to verify all levels, heights and dimensions on site and check same against drawing before putting work in hand.  
**Contractor** to locate and identify existing services on site and protect these from damage throughout the duration of works.

CONTENT
STAIRS DETAILS SCALE 1:25

STUDENT N 901006411	NAME ; RETHABILE
SCALE : 1:100	SURNAME ; RANOOE
DRAWING TITTLE : AS-BUILT	